



This document is made available through the declassification efforts
and research of John Greenewald, Jr., creator of:

The Black Vault



The Black Vault is the largest online Freedom of Information Act (FOIA) document clearinghouse in the world. The research efforts here are responsible for the declassification of hundreds of thousands of pages released by the U.S. Government & Military.

Discover the Truth at: <http://www.theblackvault.com>

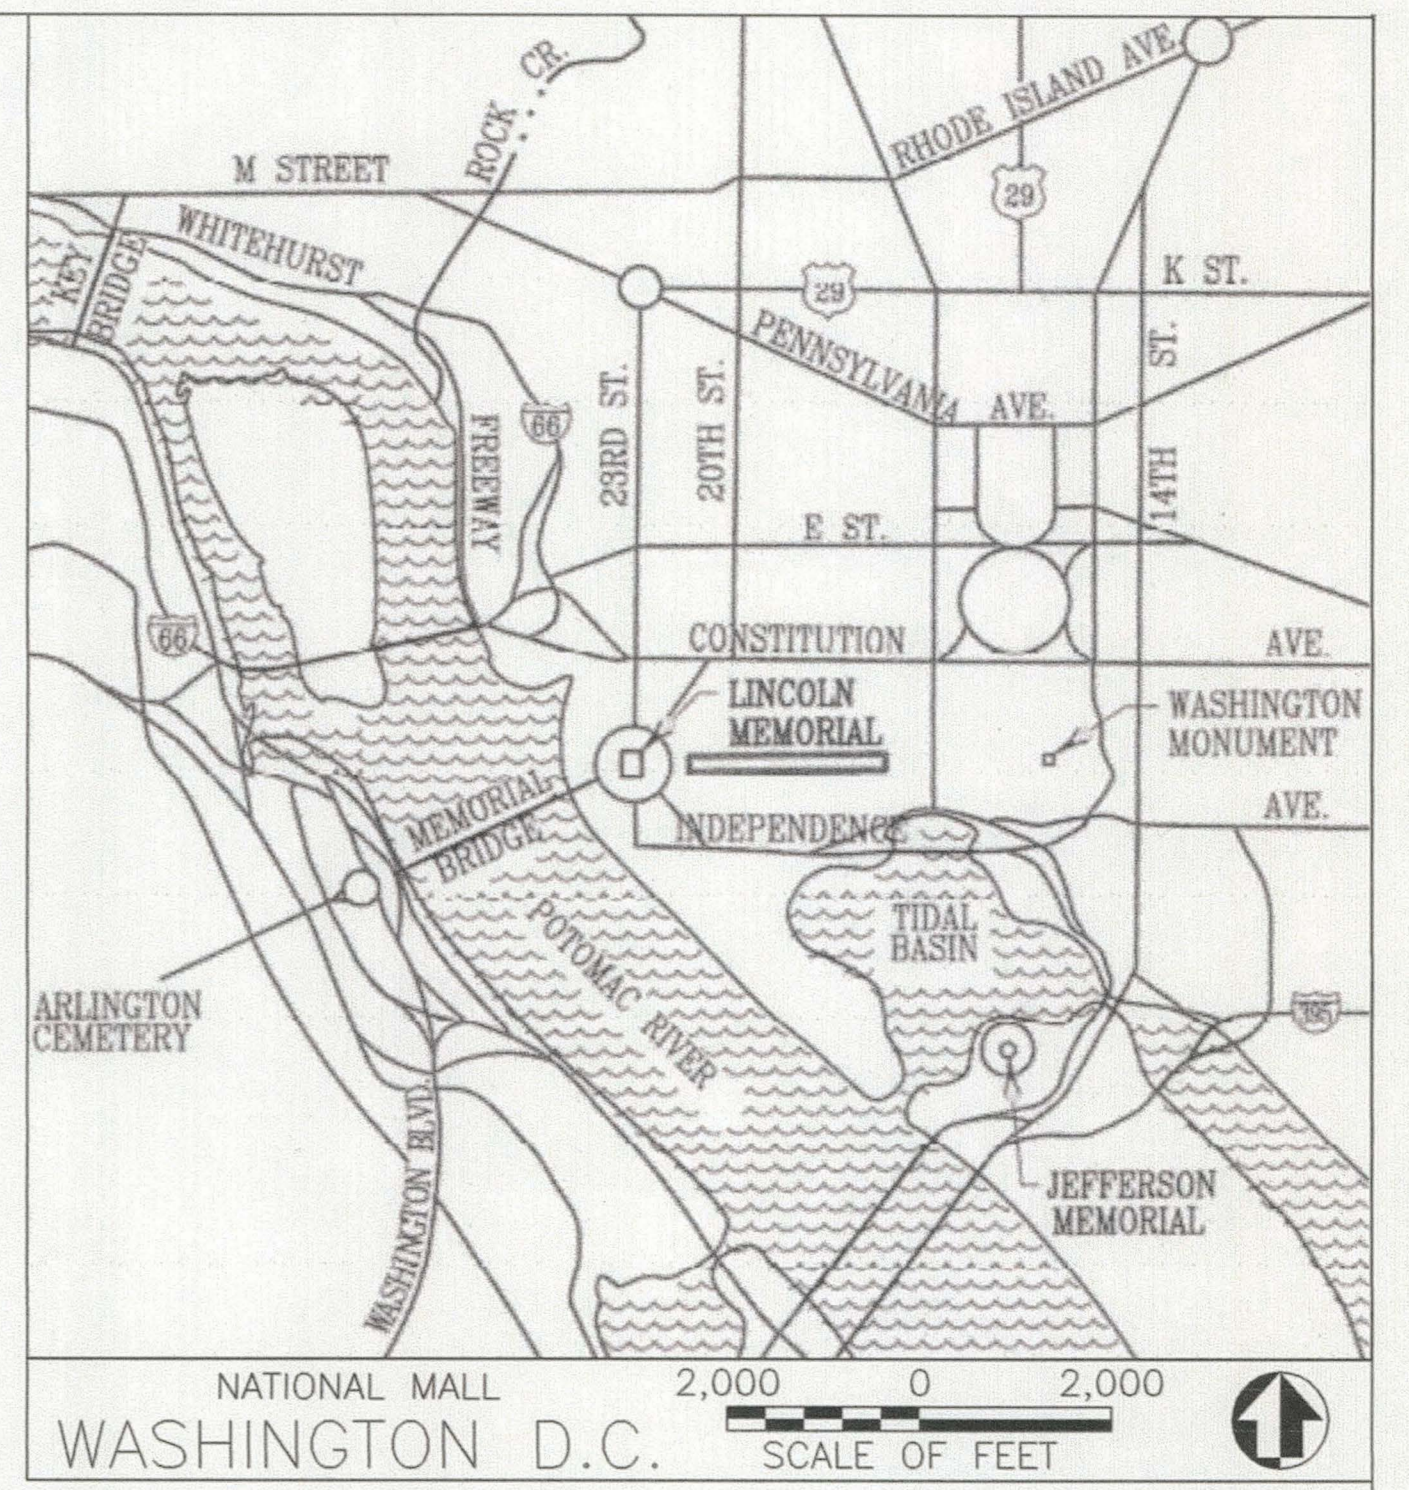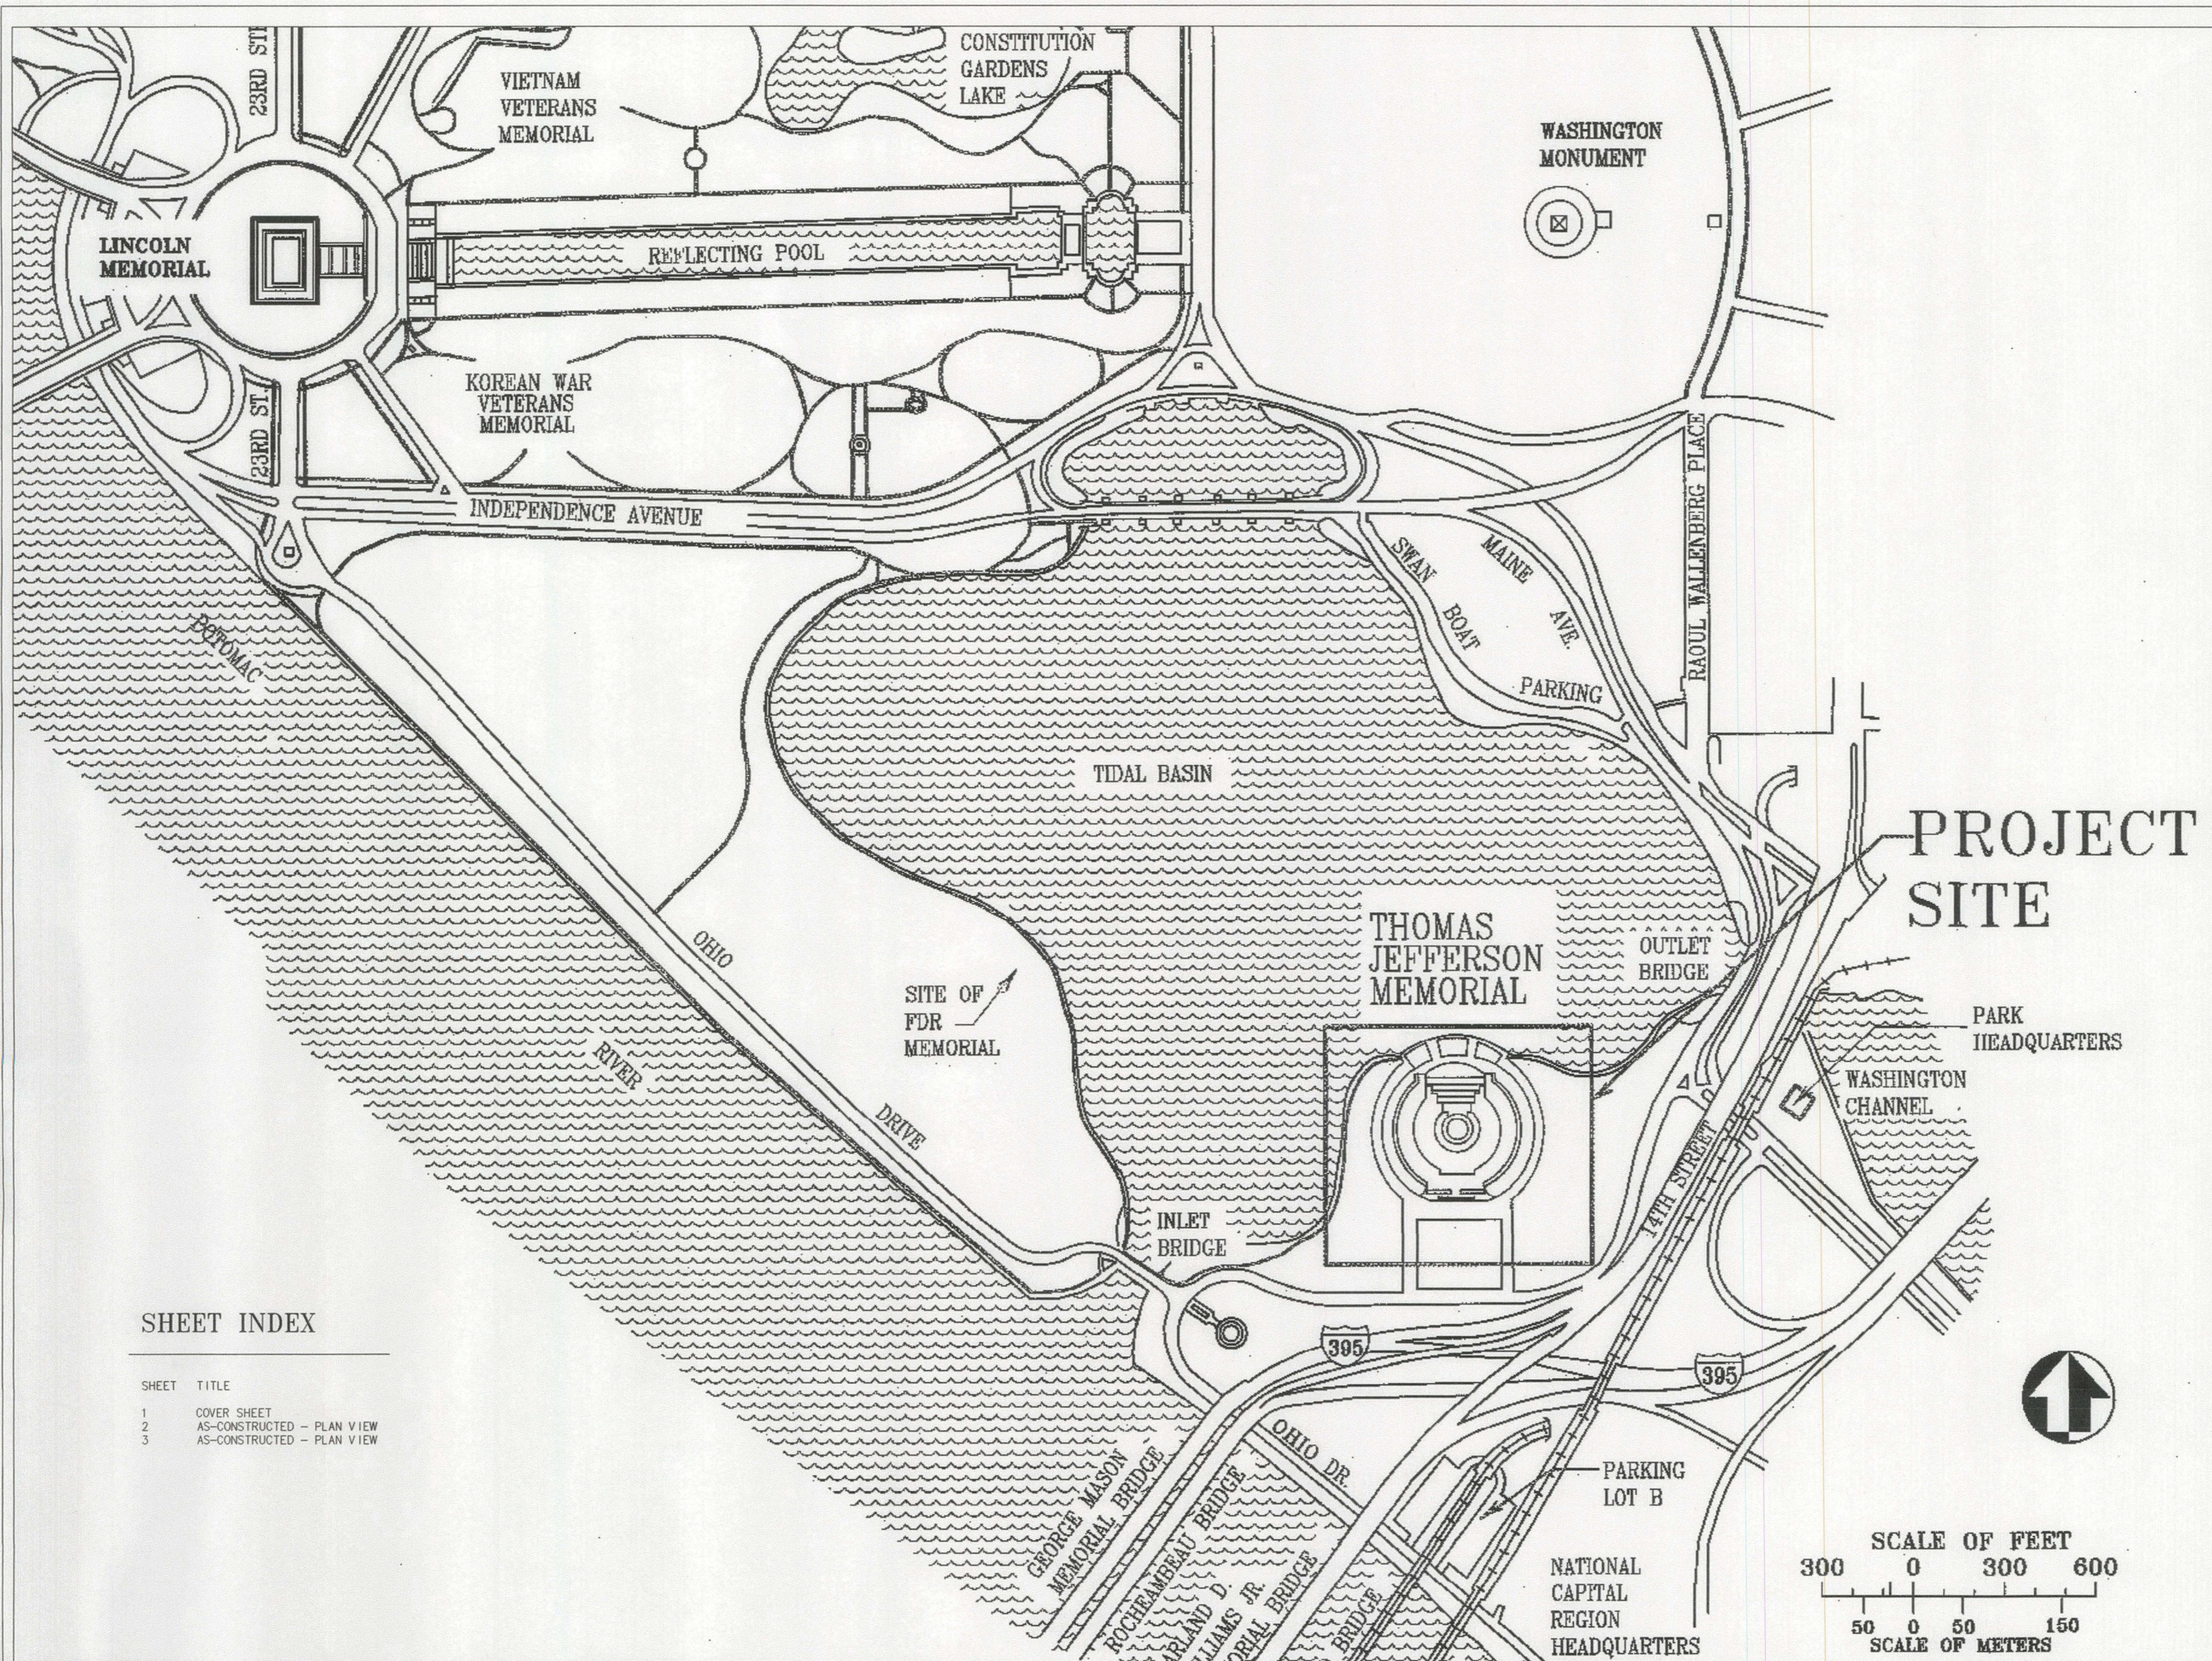

PROJECT SITE


- NOTE'S:**
- HORIZONTAL DATUM IS REFERENCED TO MARYLAND STATE PLANE MAD 83, UTILIZING EXISTING CONTROL POINTS #702 AND #703 PROVIDED BY THE CONTRACTOR (CLARK CONSTRUCTION) AS PROVIDED TO THEM BY THE NATIONAL PARK SERVICE. THE HORIZONTAL DATUM WAS ROTATED BY PERFORMING A CLOSED LOOP CONTROL TRAVERSE, ADJUSTED WITHIN REASONABLE TOLERANCES AND ROTATING ALL DATA TO THE EXISTING CONTROL POINTS AS NOTED ABOVE.
 - VERTICAL DATUM IS REFERENCED TO NATIONAL PARK SERVICE MSL 1929 DATUM, UTILIZING EXISTING CONTROL POINTS JNGS1 AND JNGS3 AS SHOWN ON SHEET 13 OF 54 OF THE CONTRACT DRAWINGS PROVIDED BY CLARK CONSTRUCTION. THE VERTICAL DATUM WAS ADJUSTED BY PERFORMING A CLOSED LEVEL LOOP WITHIN REASONABLE TOLERANCES OVER NEW CONTROL POINTS REFERENCED TO THE EXISTING BENCHMARKS NOTED ABOVE.
 - FIELD LOCATIONS AND ELEVATIONS WERE OBTAINED UTILIZING A HIGH DEFINITION SCAN DATA SURVEY SYSTEM.

SHEET INDEX


SHEET	TITLE
1	COVER SHEET
2	AS-CONSTRUCTED - PLAN VIEW
3	AS-CONSTRUCTED - PLAN VIEW

LEGEND

- LIGHT POLE
- ELECTRIC HANDHOLE
- GROUND LIGHT (FLUSH WITH CONCRETE)
- SPOT ELEVATION
- BOLLARD
- PINE TREE 4"-6"

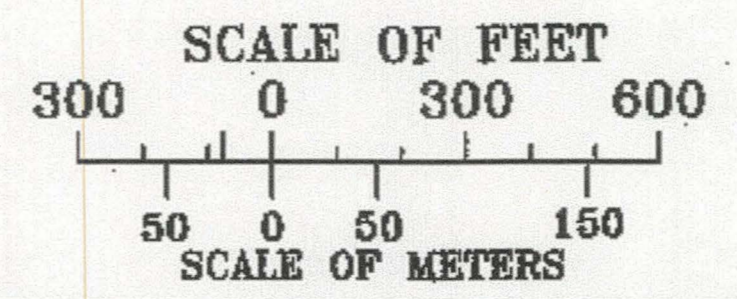

#128232

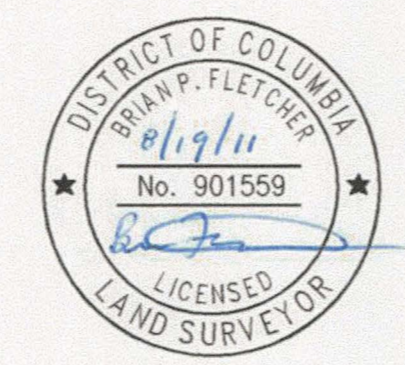

Mark	Sheet	REVISION	Date	Initial



AS-CONSTRUCTED

UNITED STATES
DEPARTMENT OF THE INTERIOR

NATIONAL PARK SERVICE
DENVER SERVICE CENTER

TITLE OF PROJECT EMERGENCY REPAIRS FOR SETTLEMENT AT JEFFERSON MEMORIAL SEAWALL LOCATION WITHIN PARK JEFFERSON MEMORIAL		DRAWING NO.
NAME OF PARK NATIONAL MALL AND MEMORIAL PARKS		PKG. NO. 128232
REGION	COUNTY	SHEET 1
NATIONAL CAPITAL	NATIONAL MALL	OF 3
WASHINGTON D.C.		

808/128922A

NOTES

MONUMENTS

NAME: (BM) JNGS1
DESCRIPTION: STEEL PLUG

N. N/A
E. N/A
ELEV. 10.83'

NAME: JNGS3
DESCRIPTION: STEEL PLUG



N. N/A
E. N/A
ELEV. 12.98'

NAME: 702
DESCRIPTION: SCRIBE


N. 442649.663
E. 1302032.219
ELEV. N/A

NAME: 703
DESCRIPTION: SCRIBE

N. 442629.584
E. 1301784.352
ELEV. N/A

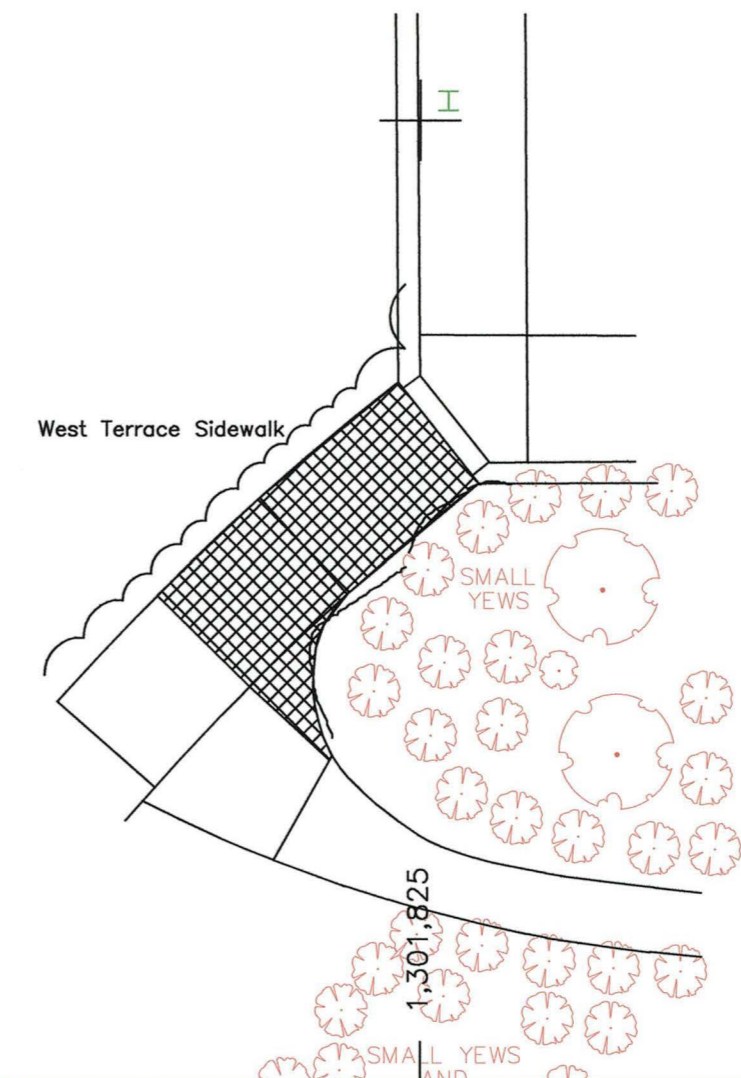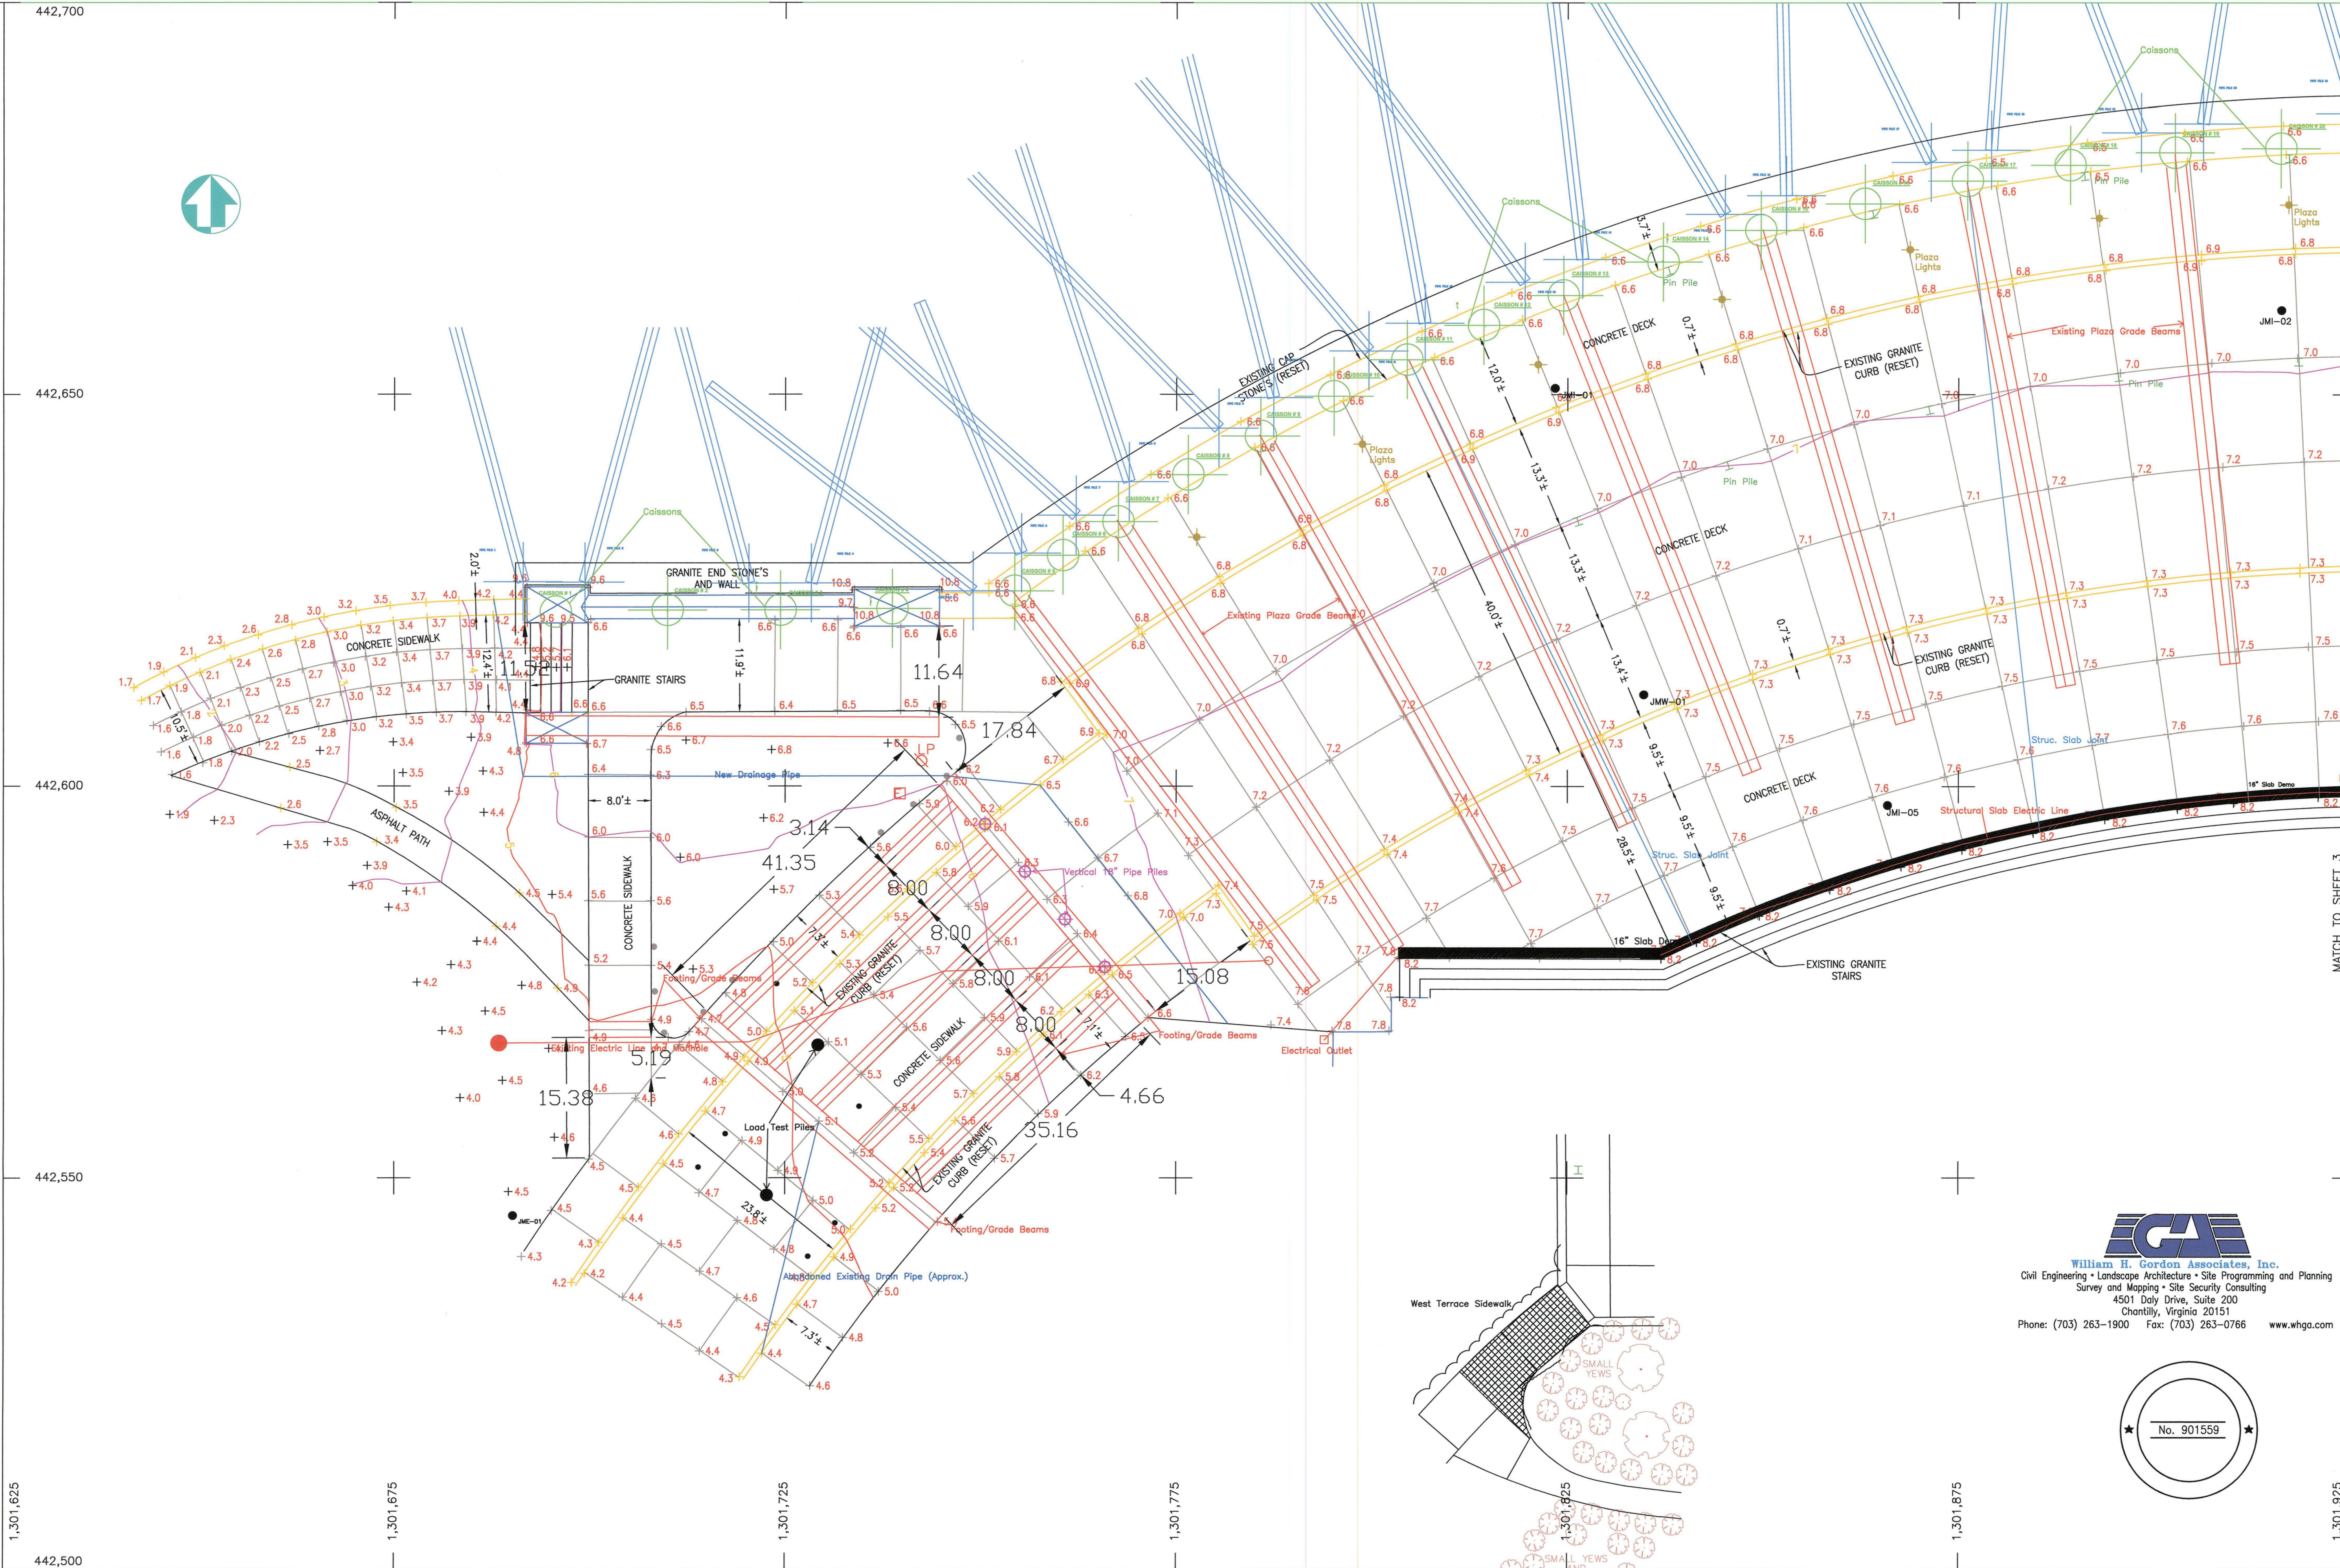


WGA
William H. Gordon Associates, Inc.
Civil Engineering • Landscape Architecture • Site Programming and Planning
Survey and Mapping • Site Security Consulting
4501 Daly Drive, Suite 200
Chantilly, Virginia 20151
Phone: (703) 263-1900 Fax: (703) 263-0766 www.whga.com

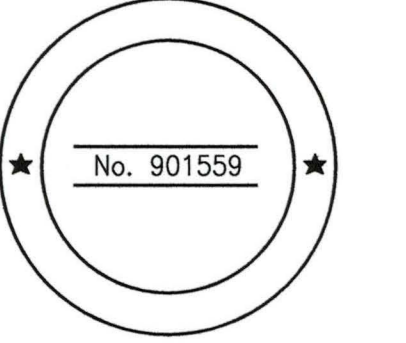

REVISIONS

BY DATE

HORIZONTAL DATUM: MARYLAND STATE PLANE NAD 83
VERTICAL DATUM: NATIONAL PARK SERVICE MSL 1929 DATUM

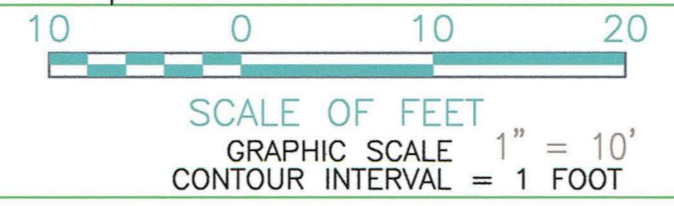

UNITED STATES
DEPARTMENT OF THE INTERIOR
NATIONAL PARK SERVICE
DENVER SERVICE CENTER

A-E FIRM
NAME: W.H. GORDON
CITY, STATE: CHANTILLY
VA
CONTRACT NUMBER:

FIELD WORK: RGG 8/11/11
DRAWN: WJB 8/18/11
CHECKED: BPF 8/19/11

TITLE OF SHEET
AS-CONSTRUCTED
EMERGENCY REPAIRS FOR SETTLEMENT
AT JEFFERSON MEMORIAL SEAWALL

PKG. NO. 128232
SHEET 2 OF 3
DRAWING NO.

808/128922A

NOTES

MONUMENTS
 NAME: (BM) JNGS1
 DESCRIPTION: STEEL PLUG

N. N/A
 E. N/A
 ELEV. 10.83'

NAME: JNGS3
 DESCRIPTION: STEEL PLUG



N. N/A
 E. N/A
 ELEV. 12.98'

NAME: 702
 DESCRIPTION: SCRIBE


N. 442649.663
 E. 1302032.219
 ELEV. N/A

NAME: 703
 DESCRIPTION: SCRIBE

N. 442629.584
 E. 1301784.352
 ELEV. N/A

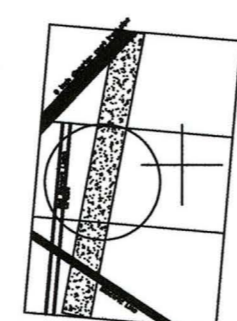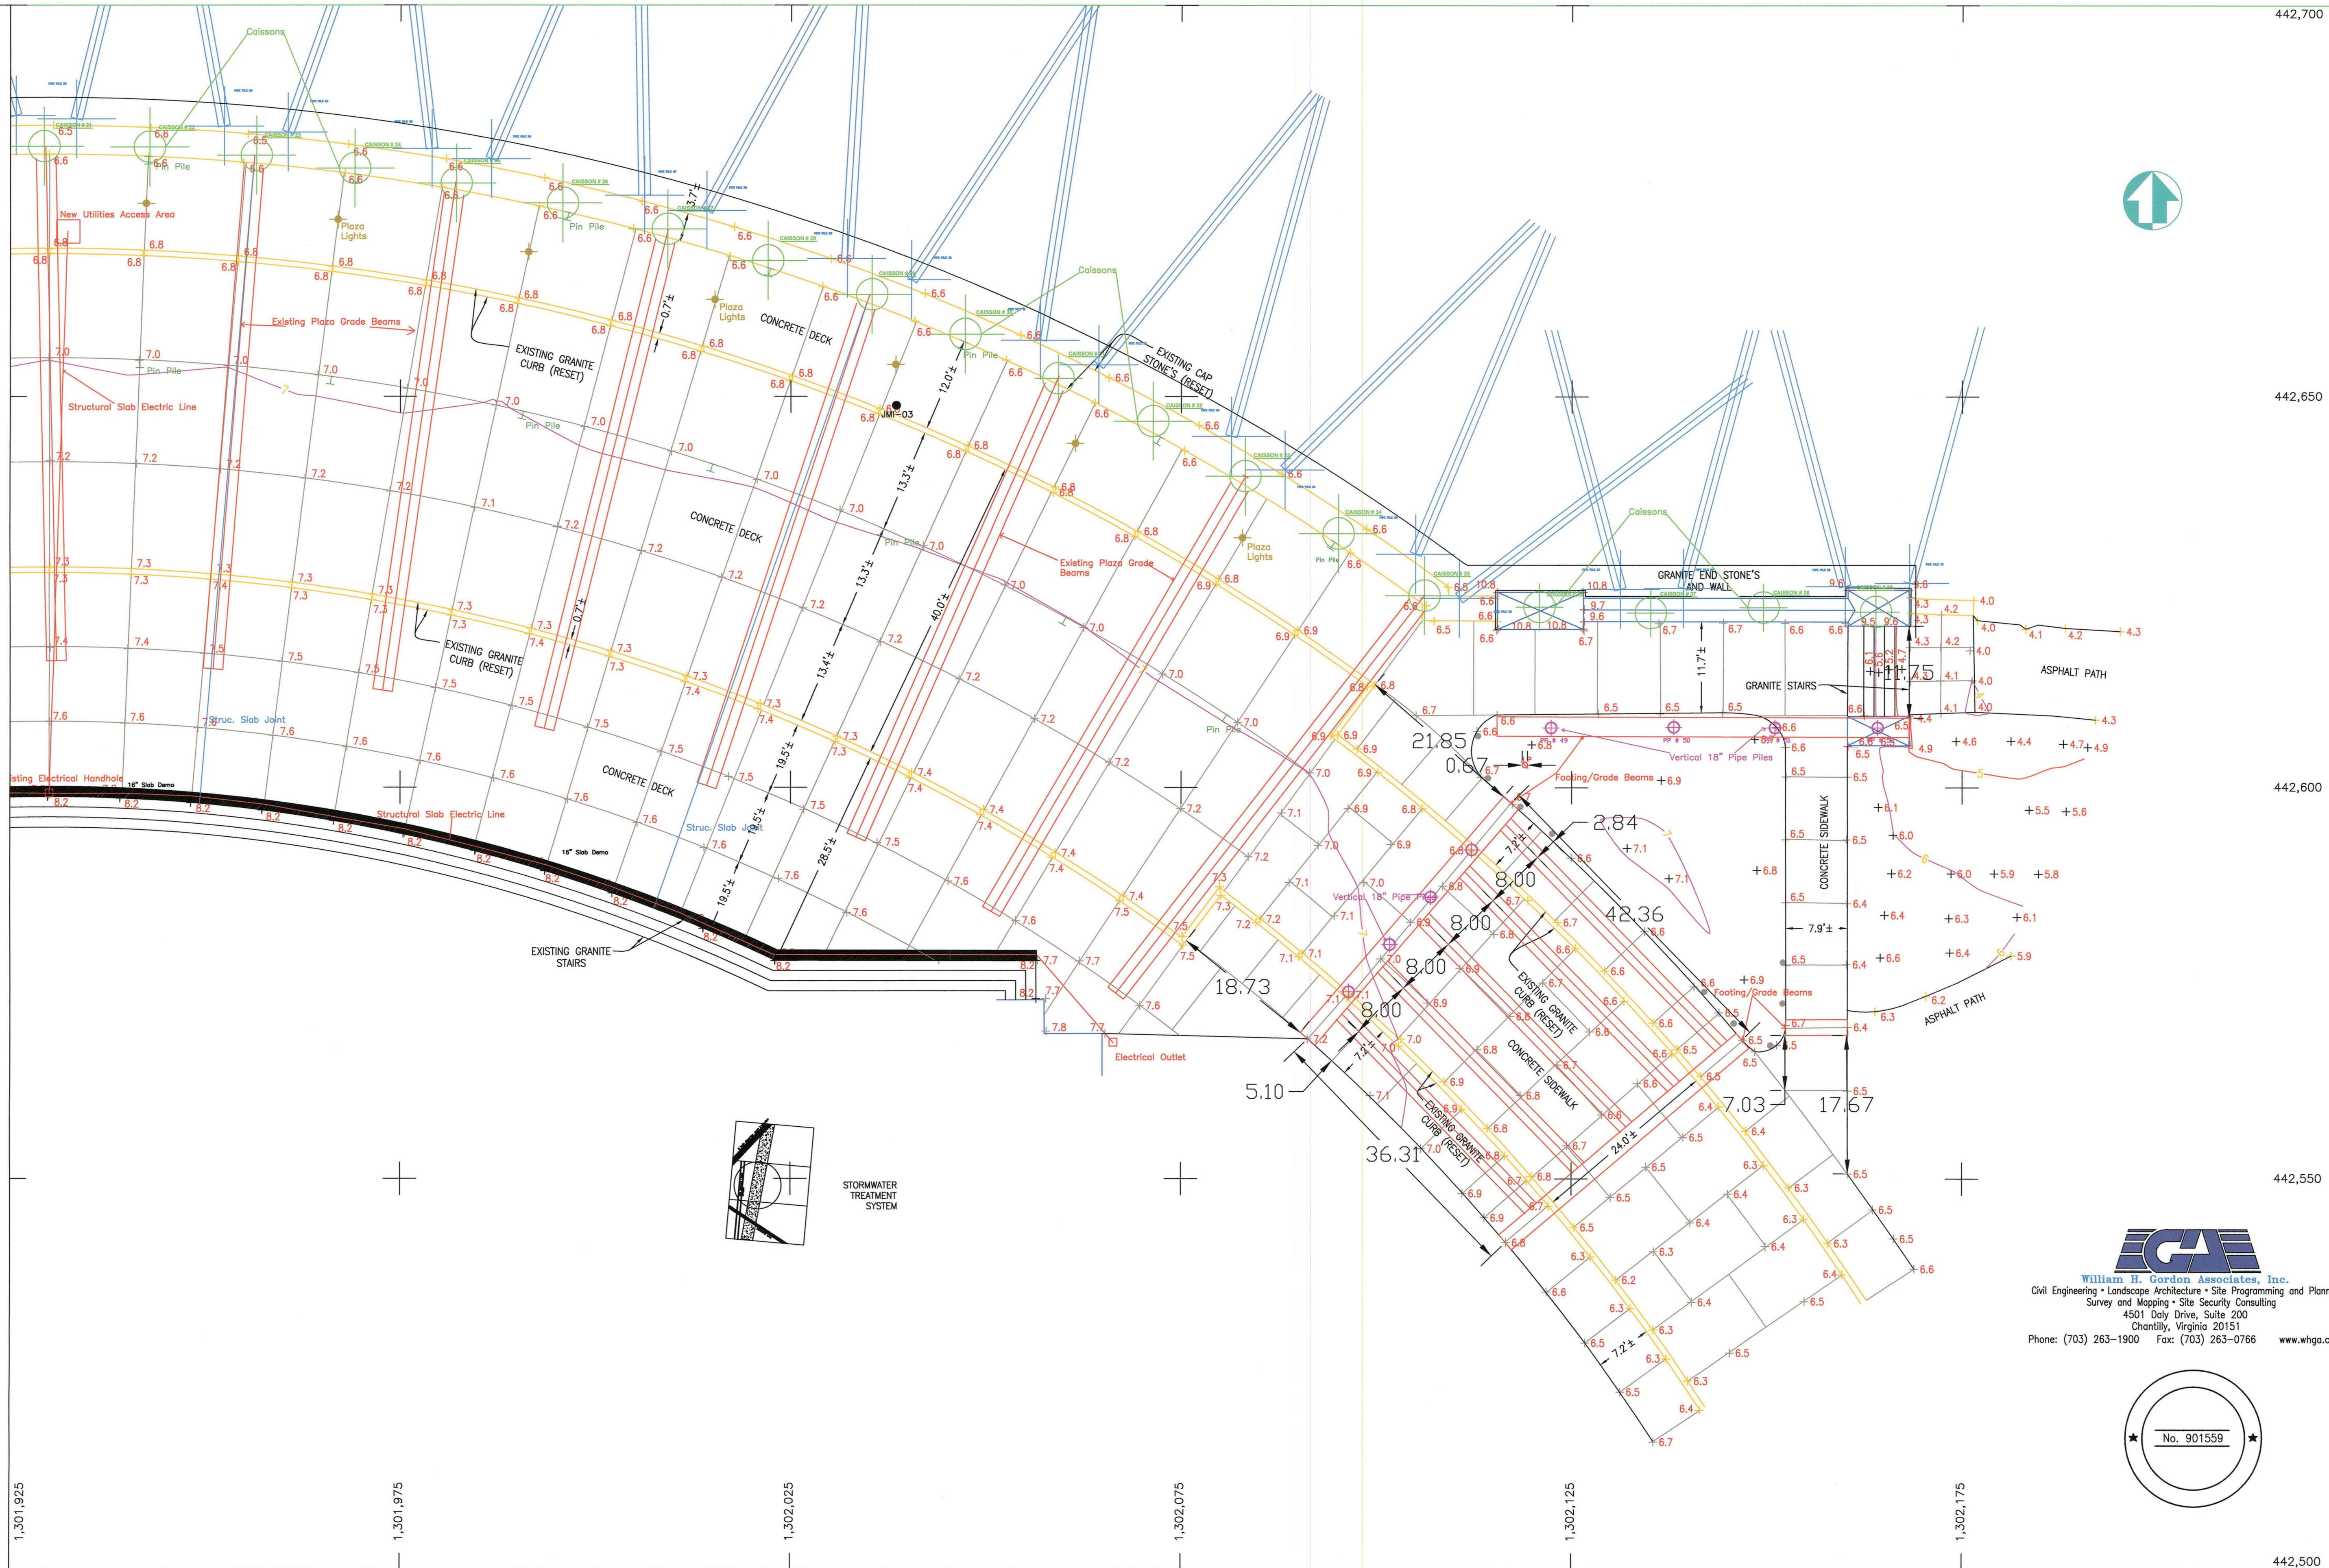

WGA
 William H. Gordon Associates, Inc.
 Civil Engineering • Landscape Architecture • Site Programming and Planning
 Survey and Mapping • Site Security Consulting
 4501 Daly Drive, Suite 200
 Chantilly, Virginia 20151
 Phone: (703) 263-1900 Fax: (703) 263-0766 www.whga.com

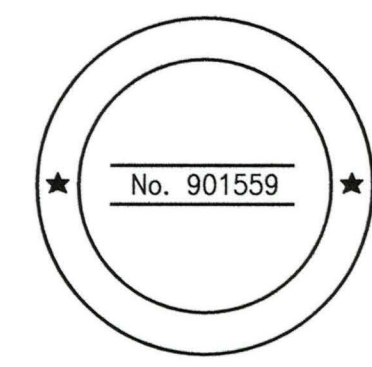

REVISIONS	BY	DATE	HORIZONTAL DATUM: MARYLAND STATE PLANE NAD 83	10 0 10 20	UNITED STATES DEPARTMENT OF THE INTERIOR	A-E FIRM NAME: W.H. GORDON CITY, STATE: CHANTILLY VA CONTRACT NUMBER:	FIELD WORK: RGG 8/11/11	TITLE OF SHEET AS-CONSTRUCTED EMERGENCY REPAIRS FOR SETTLEMENT AT JEFFERSON MEMORIAL SEAWALL	PKG. NO. 128232	SHEET 3	DRAWING NO.
			VERTICAL DATUM: NATIONAL PARK SERVICE MSL 1929 DATUM	SCALE OF FEET GRAPHIC SCALE 1" = 10' CONTOUR INTERVAL = 1 FOOT	NATIONAL PARK SERVICE DENVER SERVICE CENTER		8/18/11	CHECKED: BPF 8/19/11		OF 3	

808/128922A